

VENDOR DOC. NO.

:7S72-VP-20Z2902A/B/C-008

CLIENT DOC. NO.

:7S72-PR-EL-001

See commented sheet No.
7S72-VP-PO-EL001-009

CIVIL WORKS

PROJECT TITLE : DIESEL ENGINE GENERATOR

P.O. NO. : 7S72-PO-EL-001

VENDOR REF. NO. : SMC-CTM-001

- 1: APPROVED WITHOUT COMMENTS, VENDOR TO SUBMIT FOR FINAL.
- 2: APPROVED WITH COMMENTS, VENDOR TO AMEND AND SUBMIT FOR FINAL
- 3: APPROVED WITH COMMENTS, VENDOR TO AMEND AND SUBMIT FOR APPROVAL.
- 4: NOT REVIEWED.


THIS APPROVAL OR REVIEW DOES NOT RELIEVE THE VENDOR/SUBCONTRACTOR OF HIS RESPONSIBILITIES TO MEET ALL OF THE SPECIFIED REQUIREMENTS OF THE PURCHASE ORDER.

CODE	DESCRIPTION & INSTRUCTIONS
2.	Approved with Comments. Vendor to Amend and Submit For Final

	Salalah Methanol Project Salalah Methanol Company, LLC (FZC) Salalah, Sultanate of Oman
COMPAGNIA TECNICA MOTORI SPA, Italy	
 GS Engineering & Construction Corp. SEOUL, KOREA	

3					
2					
1					
0	03-MAR	FOR APPROVAL	NOVELLI	TURCHIARELLI	TURCHIARELLI
REV.	DATE	DESCRIPTION	PREPARED BY	CHECKED BY	APPROVED BY
					REV. 0

Commented sheet

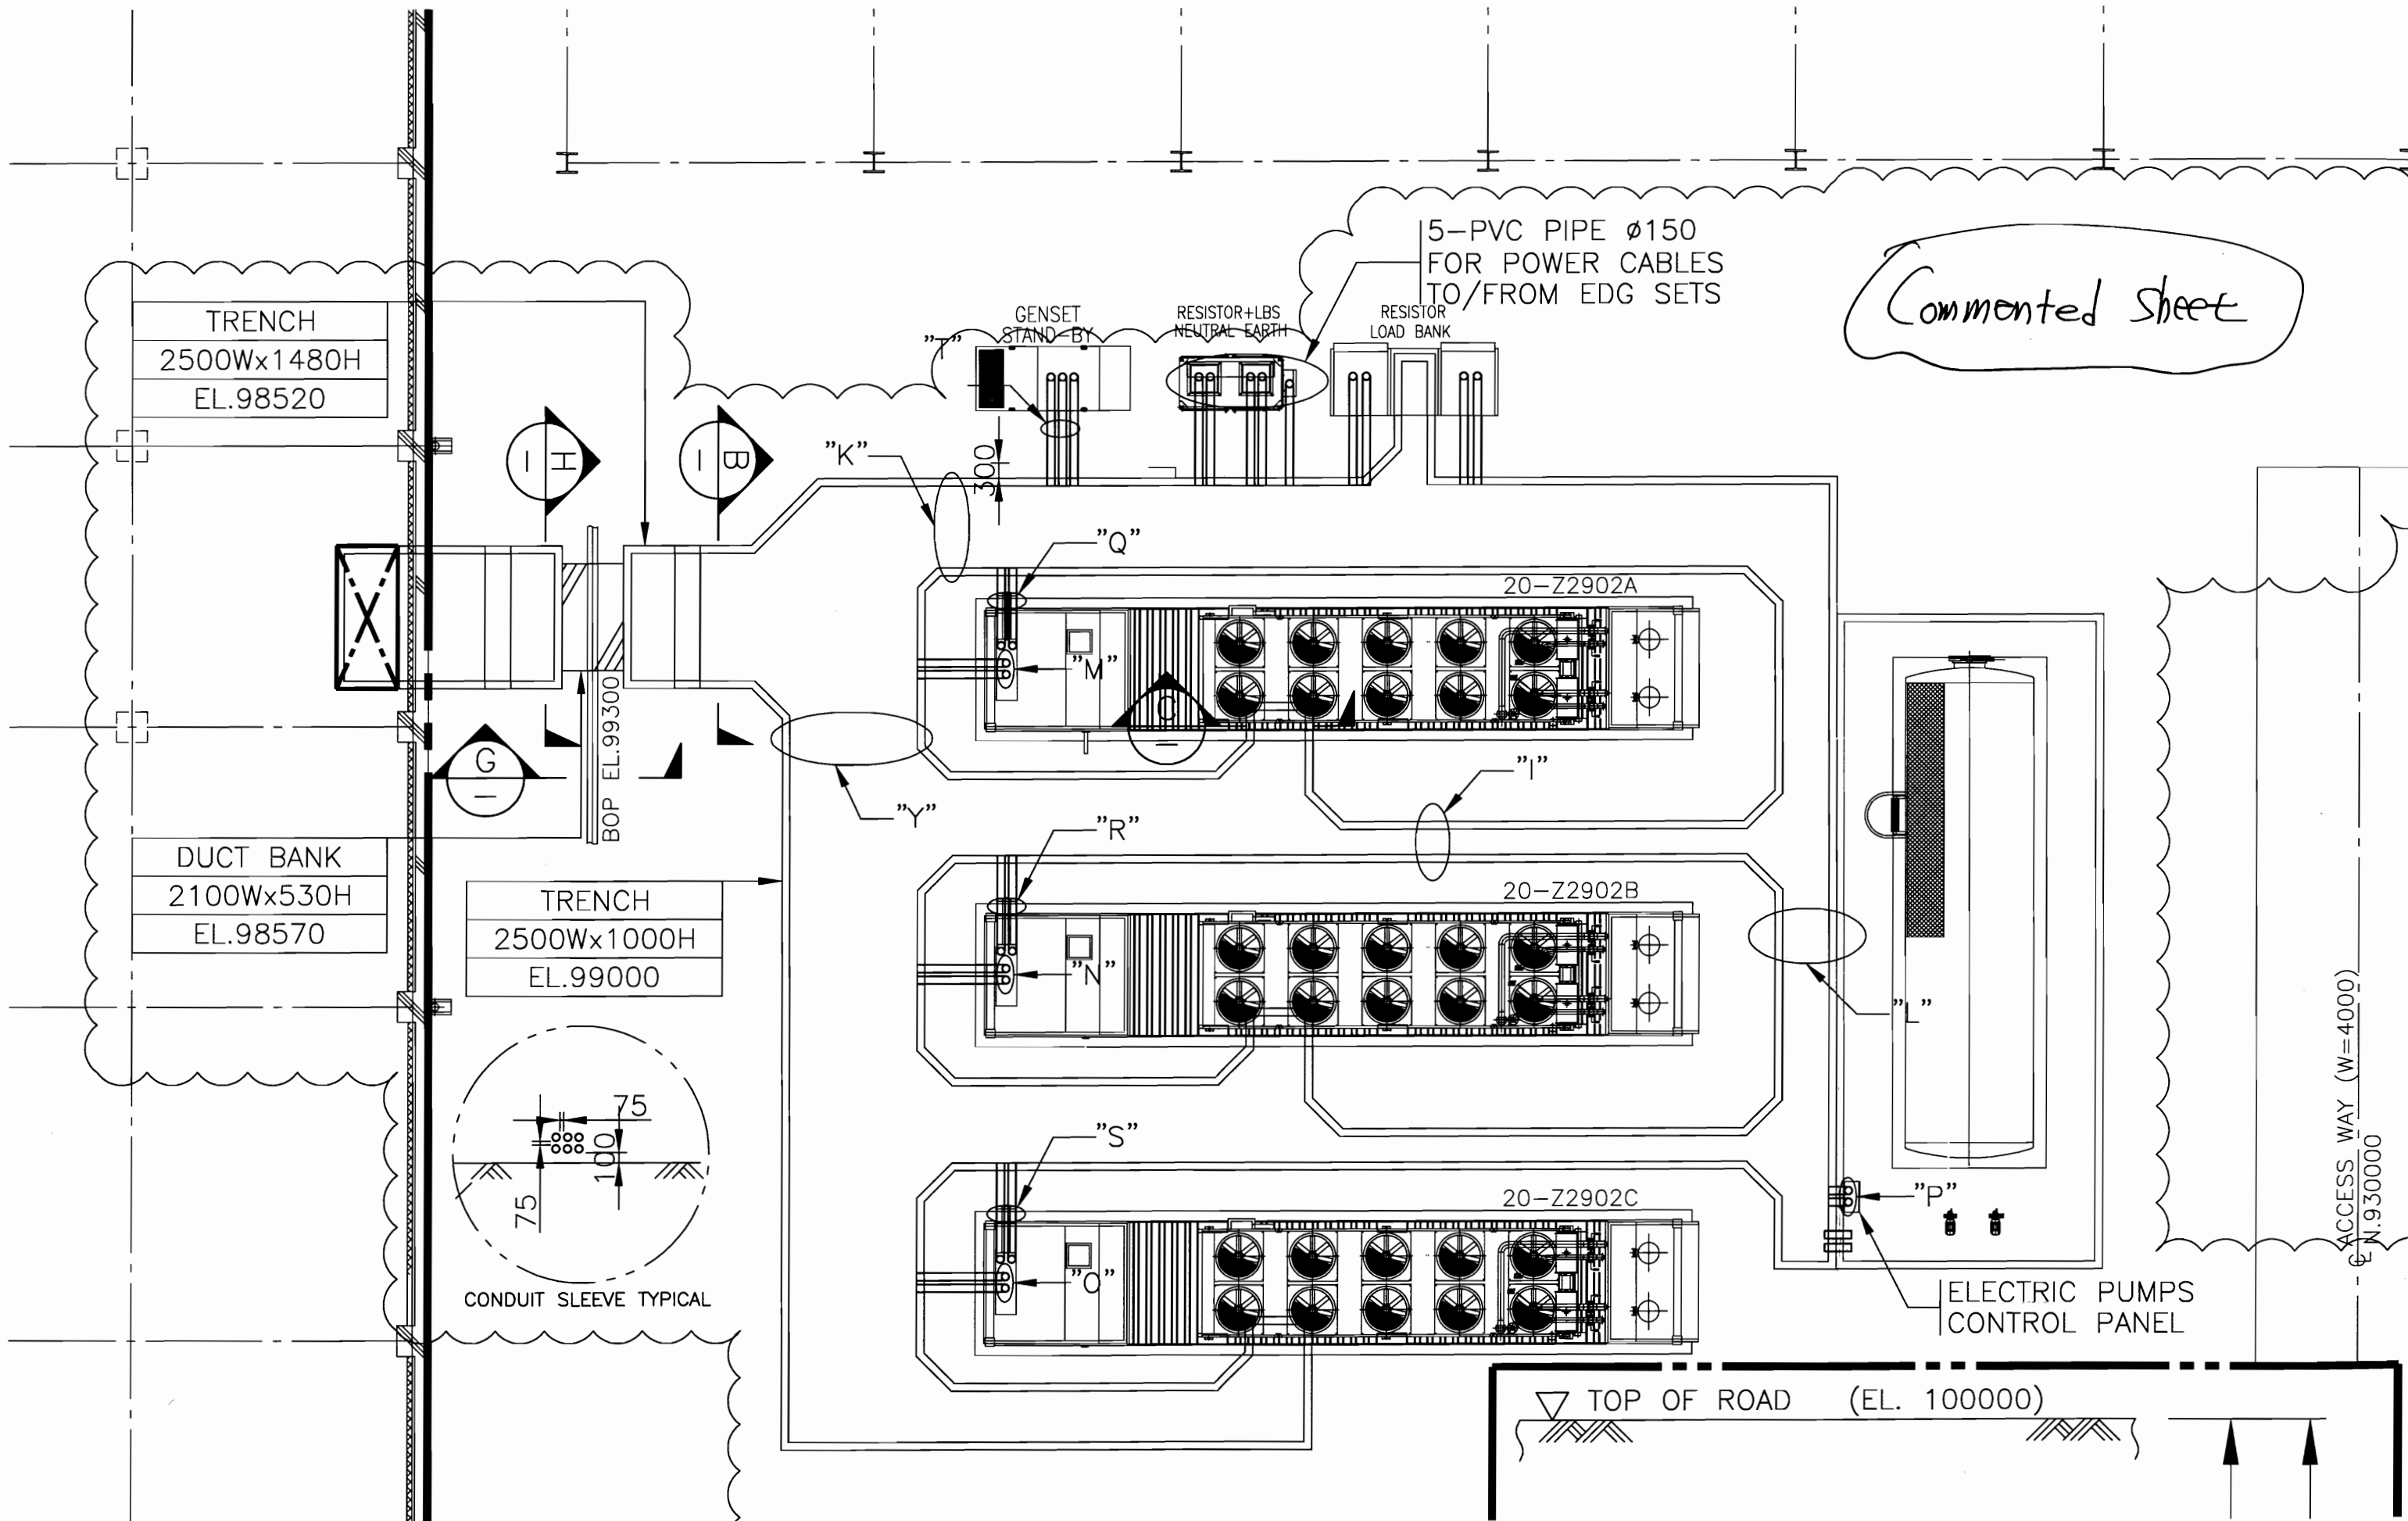

ACCESS WAY (W=4000)
EL.930000

